


REFERENCE DRAWINGS:

"GENERAL LEGEND" G002


NOTES:

ALL WORK SHOWN HEAVY LINE ON THIS DRAWING BY CONTRACT 151 (EXCEPT AS NOTED).

NEW 5" ASPHALT PAVEMENT

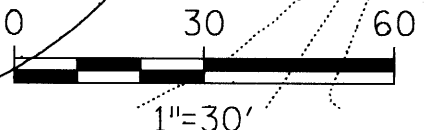

| | | | | | | | | | | | | | | | | | | | |
|---|--|---------------------------------------|--|------------------------------|--|-------------------------------|--|---------------------------------------|--|------------------------------|--|-------------------------------|--|---------------------------------------|--|------------------------------|--|-------------------------------|--|
| REVISION DWN APP DATE REVISION DWN APP DATE | | DRAWN BY DATE C.V. STELZNER 4-7-88 | | CHECKED BY NN JLC 2-16-90 | | PROJECT NO. NN JLC 2-16-90 | | DRAWN BY DATE C.V. STELZNER 4-7-88 | | CHECKED BY NN JLC 2-16-90 | | PROJECT NO. NN JLC 2-16-90 | | DRAWN BY DATE C.V. STELZNER 4-7-88 | | CHECKED BY NN JLC 2-16-90 | | PROJECT NO. NN JLC 2-16-90 | |
| 2 RECORD DRAWING 1 REVISED PER ADDENDUM 151-1 | | NN JLC 2-16-90 C.V.S. | | NN JLC 2-16-90 C.V.S. | | NN JLC 2-16-90 C.V.S. | | NN JLC 2-16-90 C.V.S. | | NN JLC 2-16-90 C.V.S. | | NN JLC 2-16-90 C.V.S. | | NN JLC 2-16-90 C.V.S. | | NN JLC 2-16-90 C.V.S. | | NN JLC 2-16-90 C.V.S. | |

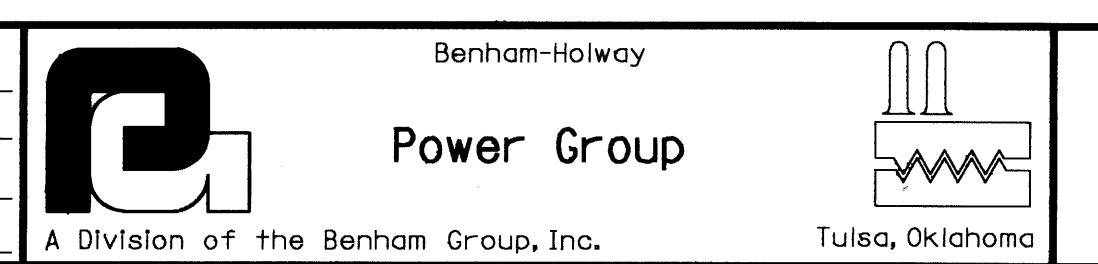

GRAND RIVER DAM AUTHORITY
 STATE OF OKLAHOMA
 COAL FIRED GENERATING STATION, UNIT NO. 1
 490 MW

Cooling Tower Modifications
SITE GRADING

SCALE: 1"=30'
 DWG. NO. 87-016-20
 C001
 REV 2