
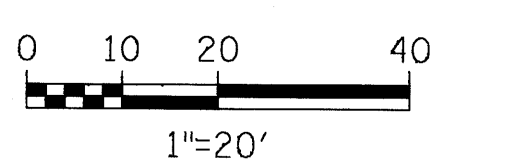


DETAIL A-M011
SCALE: NONE
M011

NOTES:
ALL WORK ON THIS DRAWING BY CONTRACT 151 (EXCEPT AS NOTED).
FOR DUCT BANK LAYOUT SEE DRAWINGS E004 AND E005.

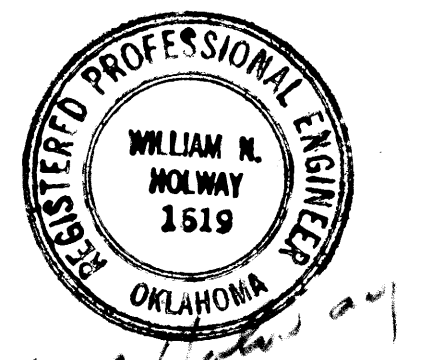

REVISION		DWN		APP		DATE		REVISION		DWN		APP		DATE			
2		RECORD DRAWING		NN		JLC		2-16-90		CVS		REDRAWN FOR ADDENDUM 151-1					
BY		C.V. STELZNER		3-25-88		CHECKED		AJAY SETH		5-31-88		SUPV. ENGR.		JIM COOMBS		5-31-88	
PROJ. MGR.		W.N. HOLWAY		6-1-88		A Division of the		Benham Group, Inc.		Tulsa, Oklahoma		GRDA		Cooling Tower Modifications		SCALE: 1"=20'-0"	
GRAND RIVER DAM AUTHORITY										STATE OF OKLAHOMA		COAL FIRED GENERATING STATION, UNIT NO. 1		490 MW		SITE UTILITIES AND STRUCTURES	
UNIT NO. 1 COOLING TOWER AREA										SHEET 1		M011		REV 2			